


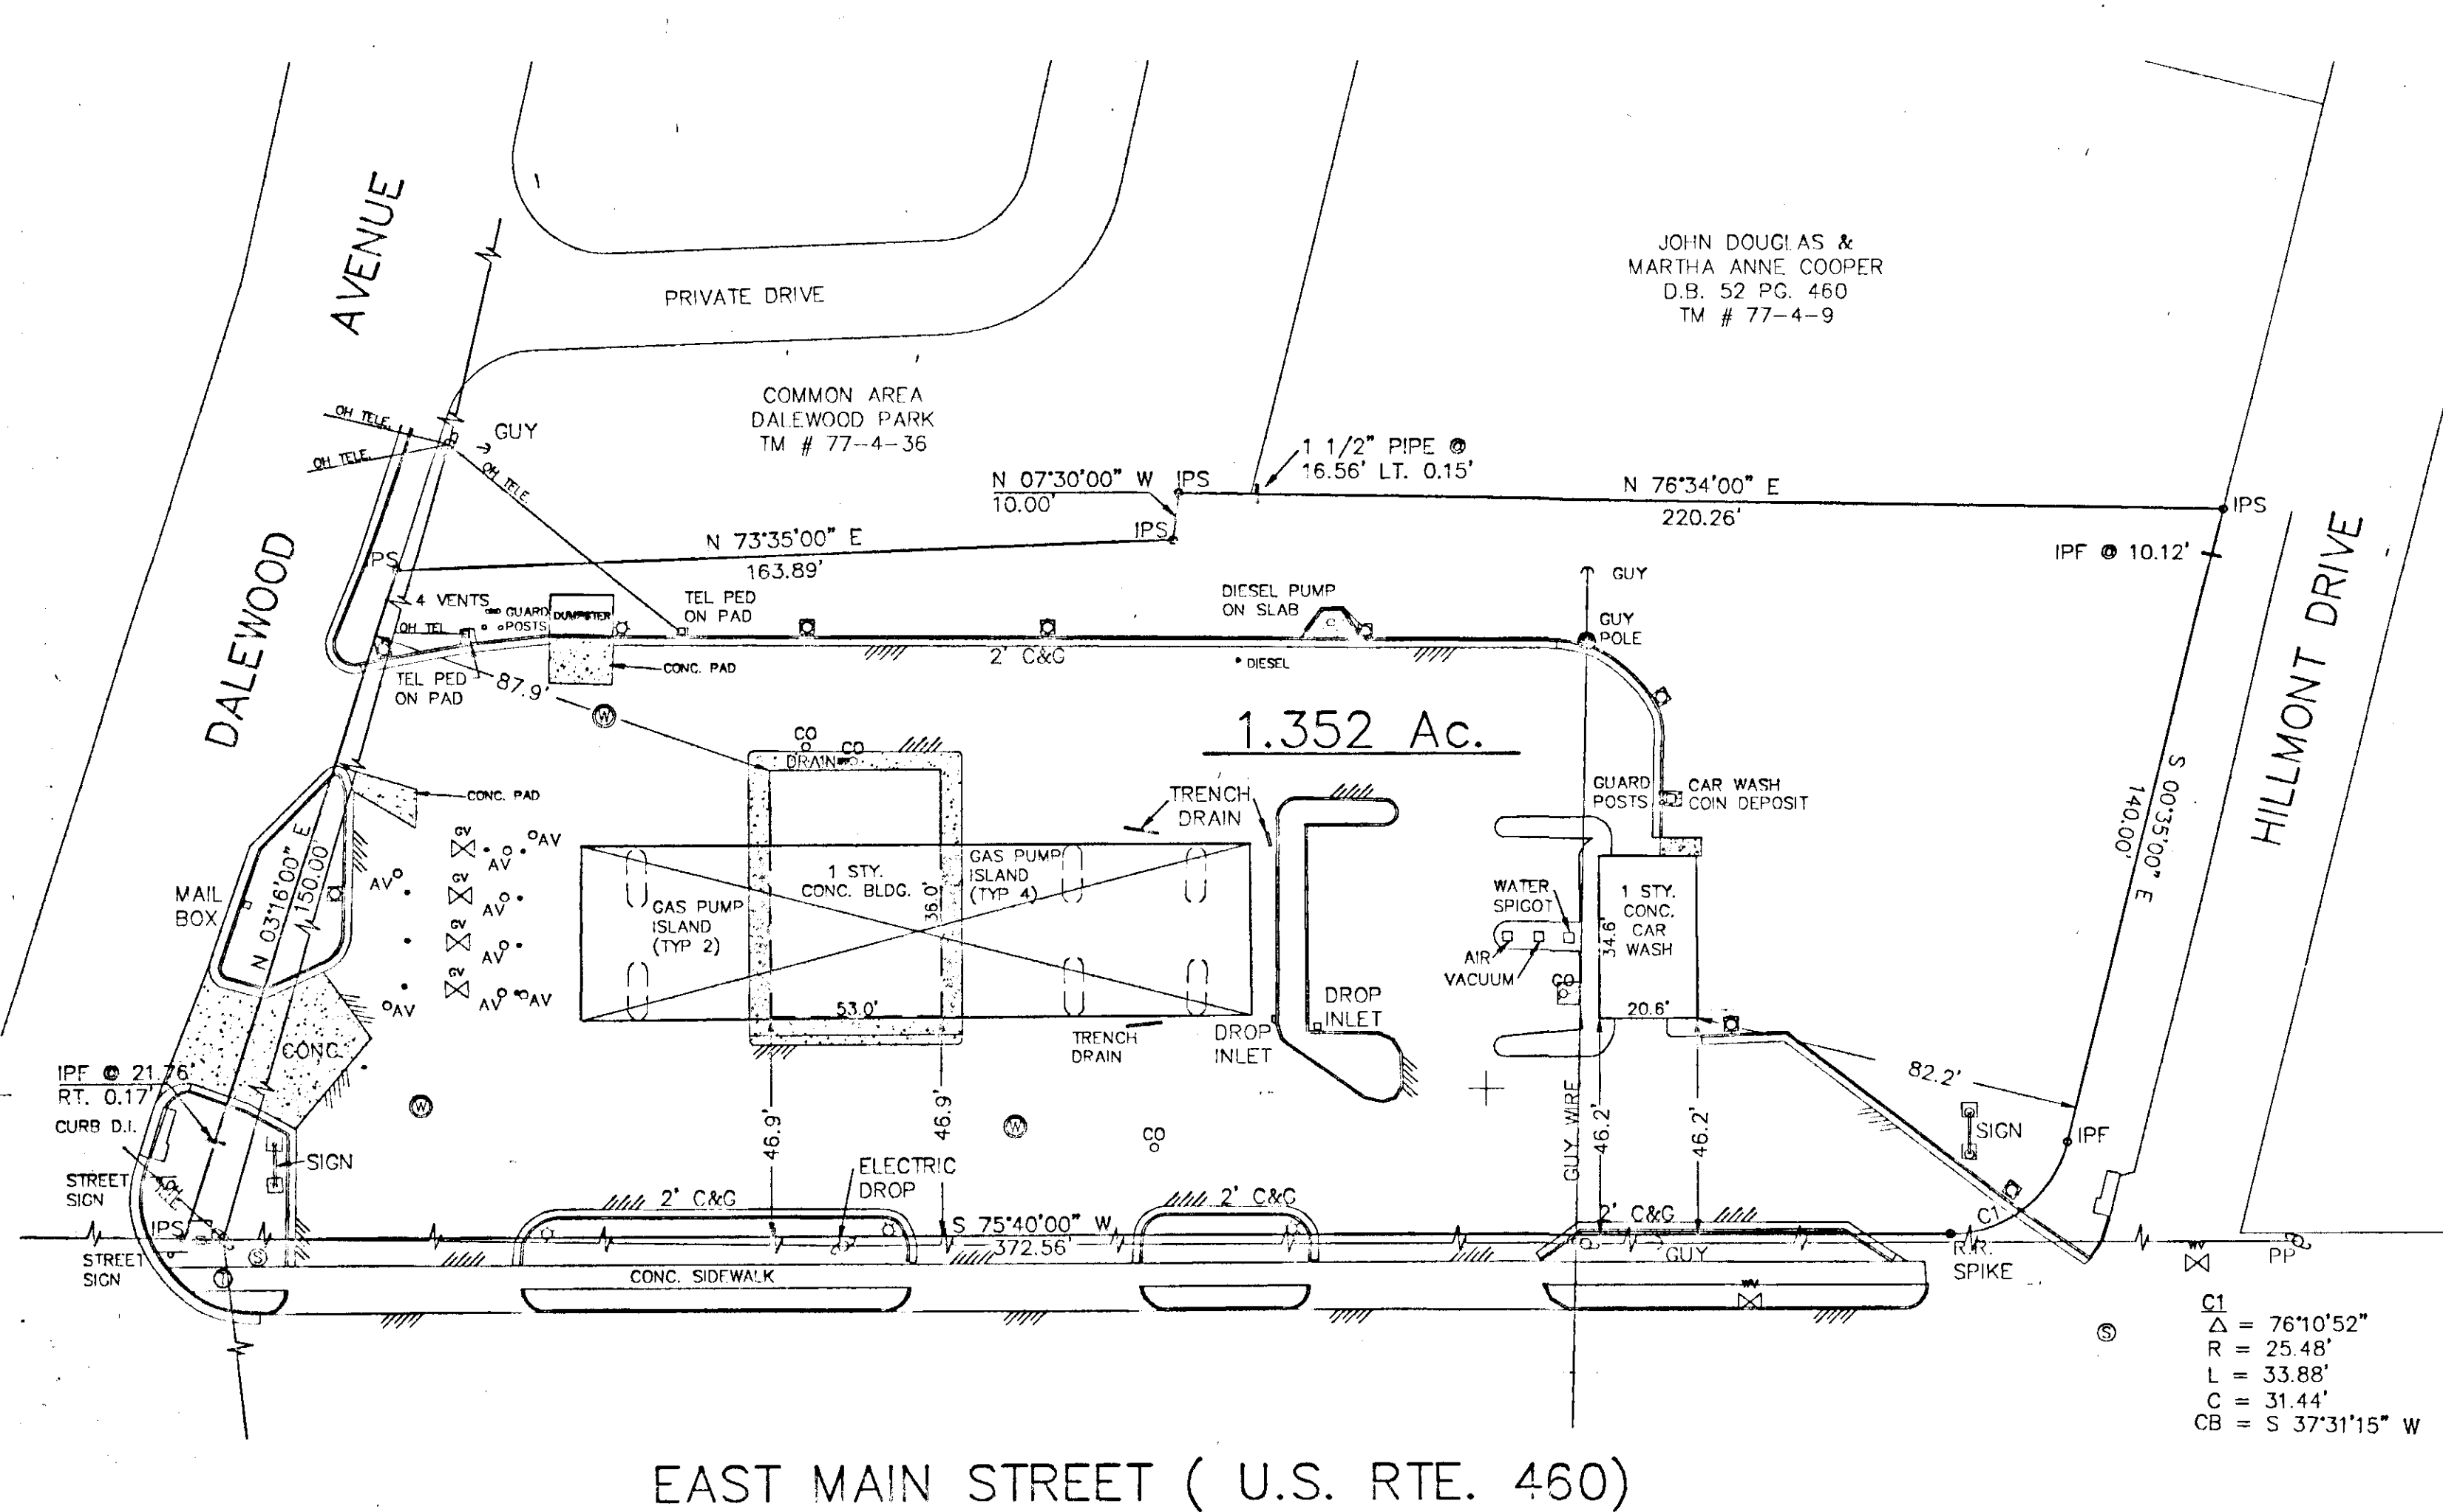


# LEGEND

|       |                          |
|-------|--------------------------|
| — T — | UNDERGROUND TELEPHONE    |
| — E — | UNDERGROUND ELECTRIC     |
| — / — | OVERHEAD ELECTRIC        |
| ⊙     | SAINTARY SEWER MANHOLE   |
| •     | GAS FILLER CAP           |
| □     | SQUARE METAL COVER       |
| ☆     | LIGHT                    |
| ⊠     | LIGHT WITH CONCRETE BASE |
| ⊗     | MONITORING WELL          |
| ⊕     | WATER VALVE              |
| C&G   | CURB AND GUTTER          |
| IPF   | IRON PIN FOUND           |
| IPS   | IRON PIN SET             |
|       | EDGE OF PAVEMENT         |
| ⊙     | TELEPHONE MANHOLE        |
| ⊕     | UTILITY POLE             |
| ⊗     | GASOLINE SHUT-OFF VALVE  |
| ⊕     | GASOLINE TANK VENT       |

C1  
 $\Delta = 76^{\circ}10'52''$   
 $R = 25.48'$   
 $L = 33.88'$   
 $C = 31.44'$   
 $CB = S 37^{\circ}31'15'' W$

## NOTES:

- THIS PROPERTY IS LOCATED IN ZONE 'C' AND IS NOT LOCATED WITHIN FLOOD HAZARD ZONE 'A' FOR A 100 YEAR FLOOD AS DETERMINED BY F.E.M.A. AND SHOWN ON THEIR MAP DATED SEPTEMBER 1, 1978 AND REVISED NOVEMBER 16, 1983.
- THIS DRAWING HAS BEEN PREPARED FROM AN ACTUAL FIELD SURVEY AS PER DATE OF THIS PLAT. THERE ARE NO ENCROACHMENTS OR PHYSICAL EVIDENCE OF EASEMENTS EXCEPT AS SHOWN.
- ALL UNDERGROUND UTILITIES SHOWN ARE ONLY APPROXIMATE AND HAVE NOT BEEN FIELD VERIFIED.

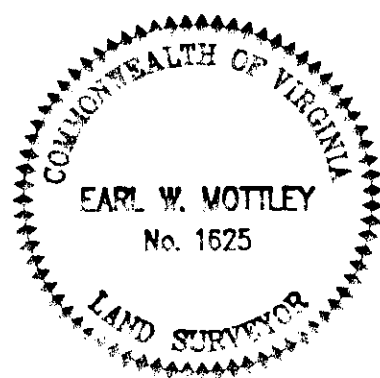

Filed in the Clerk's office  
 Circuit Court, City of Salem,  
 Va., July 4, 1994  
 Teste: *Debra A. Taylor* Deputy Clerk

|                                                                                                                                                                                                                            |  |                |                    |
|----------------------------------------------------------------------------------------------------------------------------------------------------------------------------------------------------------------------------|--|----------------|--------------------|
| <br><b>Hurt &amp; Proffitt, Inc.</b><br>ENGINEERING • SURVEYING • ENVIRONMENTAL • SITE PLANNING<br>MATERIALS TESTING • GEOTECHNICAL<br>2524 Langhorne Road<br>Lynchburg, Virginia 24501<br>(804)847-7796 FAX (804)847-0047 |  | Sheet # 1 OF 1 | Rev.:              |
|                                                                                                                                                                                                                            |  | G.L. # 260     | Date: MAY 18, 1994 |
|                                                                                                                                                                                                                            |  | Dr. By: JKL    | Comm. # 944412     |
|                                                                                                                                                                                                                            |  | File # SM-594  |                    |
| 30 15 0 30 60<br>GRAPHIC SCALE IN FEET                                                                                                                                                                                     |  |                |                    |
| PLAT SHOWING<br><b>AS-BUILT SURVEY</b><br><b>AMERICAN OIL COMPANY PROPOERTY</b><br>SALEM, VIRGINIA                                                                                                                         |  |                |                    |